



3 SECOND FLOOR PLAN
SCALE: 3/16" = 1'-0"
OFFICES
U.G. 6B
40 PERSONS

SECOND FLOOR DOOR SCHEDULE:

- 01 04
3'-0"x7'-0" HOLLOW METAL DOOR AND FRAME. 1HR. F.P.S.C.
- 02 03
3'-0" x 8'-8" x 1/2" THICK TEMPERED FRAMELESS GLASS WITH PIVOT HINGES.
- 05 06 07
3'-0"x7'-0" FLUSH SOLID CORE PAINTED WOOD DOOR. SCHLAGE PRIVACY LOCK AL40S-E76 WITH SATURN LEVER HANDLE, 626 FINISH, SATIN CHROMIUM PLATED. 1 1/2" PAIR BUTT HINGES, SILENCERS.

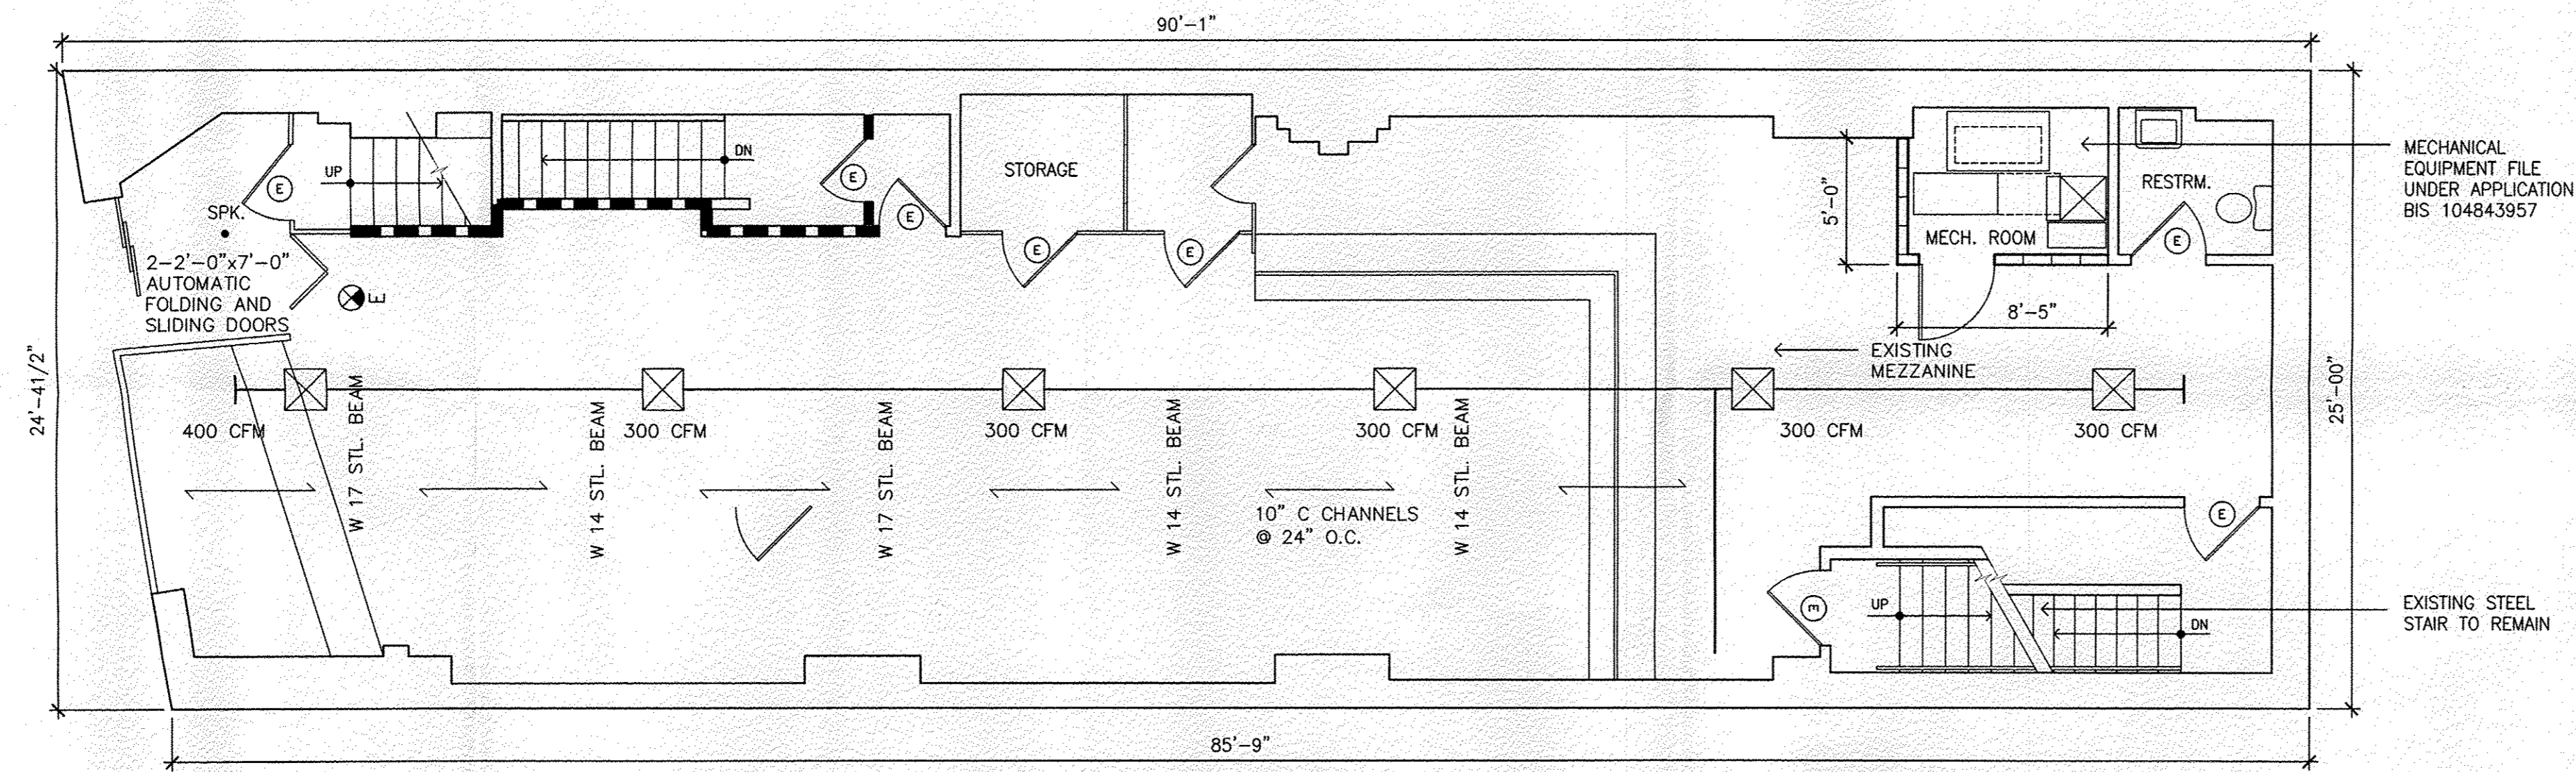

2 FIRST FLOOR PLAN
SCALE: 3/16" = 1'-0"
STORE
U.G. 6A
70 PERSONS
2,214.14 SF.
(1,750 SF. NET AREA)
NOTE: SPRINKLER SYSTEM FOR FIRST AND SECOND FLOOR FILED UNDER APPLICATION BIS 104742584

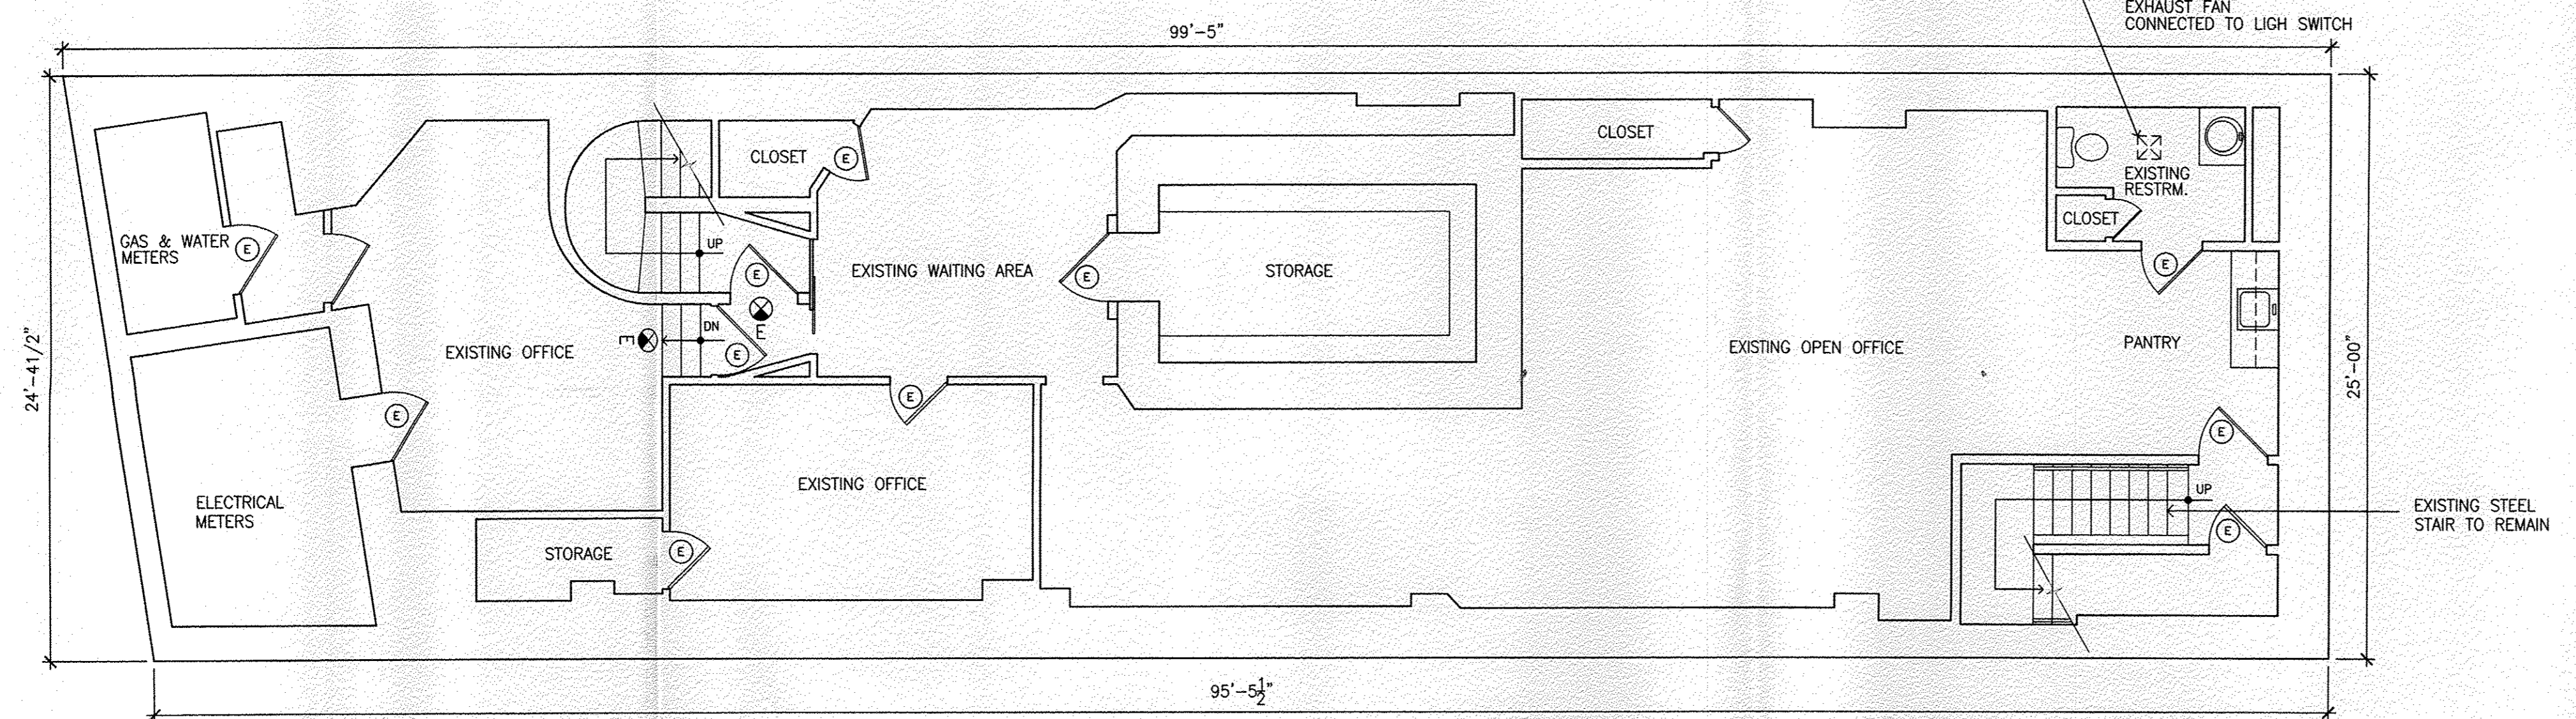

1 CELLAR FLOOR PLAN
SCALE: 3/16" = 1'-0"
OFFICE
U.G. 6A
10 PERSONS
2,143.75 SF.
NOTE: SPRINKLER SYSTEM CELLAR FLOOR FILED UNDER APPLICATION BIS 103852136

PROJECT:

DEVELOPERS:

CONSULTANTS:

REVISIONS:

No.	Description	Date
1	PAA AS BUILT CONDITIONS	09.27.07
2	PAA	02.08.17

THESE ARCHITECTURAL DOCUMENTS CONSTITUTE ORIGINAL AND UNPUBLISHED WORK OF THE ARCHITECT AND MAY NOT BE USED, DISCLOSED OR DUPLICATED IN ANY FORM OR MEAN WITHOUT WRITTEN AUTHORIZATION OF THE ARCHITECT

ARCHITECTURAL SOLUTIONS
3815 PUTNAM AVENUE WEST, SUITE M2
BRONX, NY. 10463
TEL.: 718-884-4030
FAX: 718-884-4050

PROJECT LOCATION:
CASTLE CASHING SERVICES
4186 BROADWAY
NEW YORK, NY. 10033

DRAWING TITLE:
FLOOR PLANS

SEAL	JOB NO.: 10706	DRAWN BY: ROSSY ROBLES
	SCALE: AS NOTED	DATE: 01/19/2017
	DRAWING NO.:	A-2